



John Day – North Fish Ladder Entrance Improvements: Proposed Closure of South Entrance






FFDRWG 1 March 2011 Sean Tackley (503-808-4751)






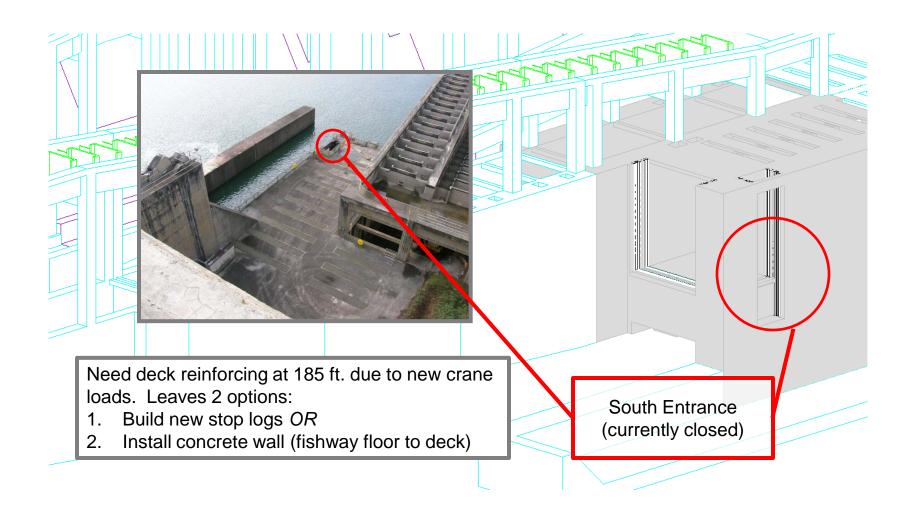






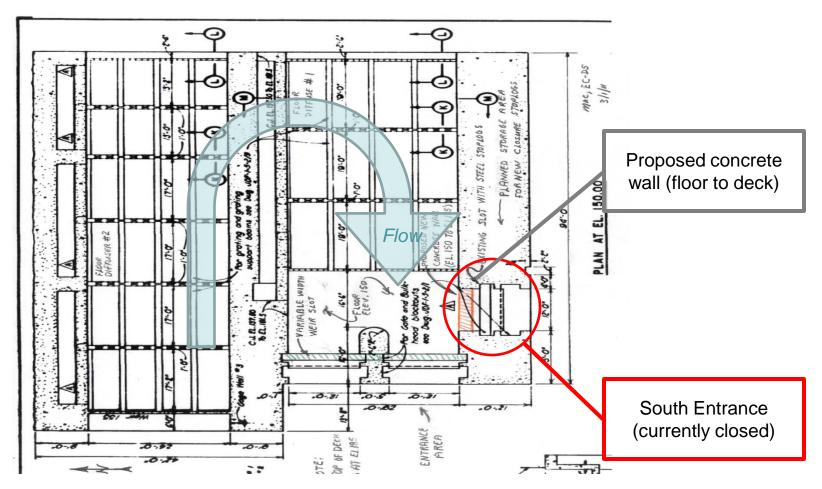

- Concrete wall on inside of fishway would be ~35 high (floor of fishway to deck)
- Eliminates need to install & maintain stop logs at this unused entrance
- Other design features?






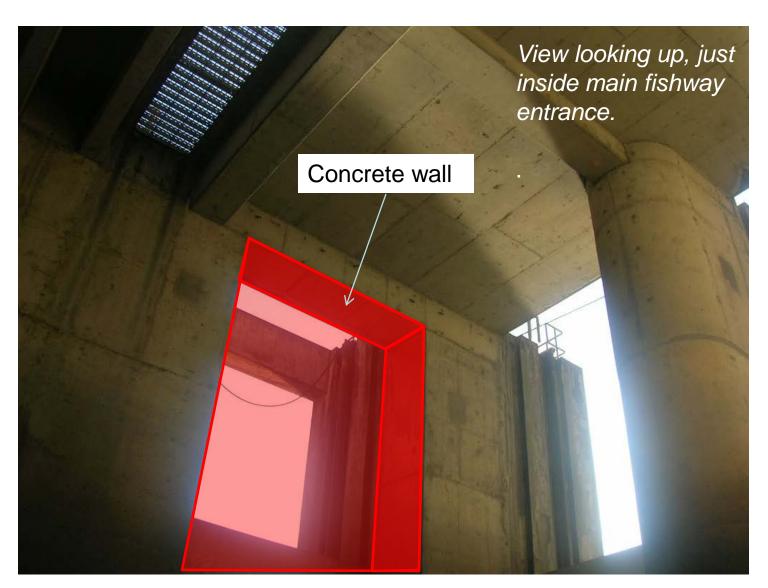





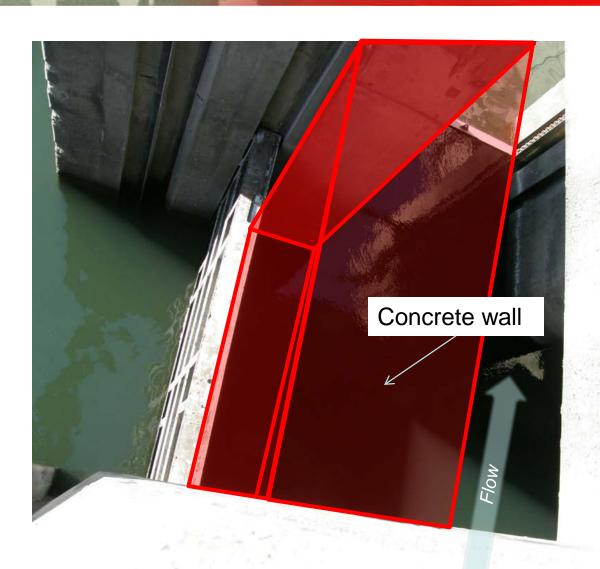

View looking down on South Entrance (main fishway entrance is in upper right corner).

Red lines
approximate the
size and shape of
the proposed
concrete wall.





John Day – North Fish Ladder Entrance Improvements: Proposed Closure of South Entrance

PROS:

- Improved hydraulics
- Cheaper construction
- Easier to maintain (and fewer leaks)
- Can be designed for relatively easy removal

CONS:

- Semi-permanent closure of South Entrance (Emergency ops?)
- Unknown impacts on lamprey passage (likely none)